

165459



## EXPLORER PIPELINE COMPANY

February 13, 1973

Re: R/W 532-10 H. W. Wiese  
St. Clair County, Illinois

Mr. H. W. Wiese  
205 Graybridge Road  
St. Louis, Missouri

Dear Mr. Wiese:

In accordance with the right of way agreement you executed on May 17, 1972, we have attached a plat (Drawing No. 532-LP-1006) to the agreement and are placing it of record in St. Clair County, Illinois. The drawing reflects the as-built location of Explorer's pipeline across your property in Sauget, Illinois.

For your information and files we are enclosing two prints of the as-built drawing.

Let me take this opportunity to thank you again for your co-operation and assistance in this matter.

Very truly yours,

*A. B. Kelhofer*  
A. B. Kelhofer


ABK:km  
encs.

*10' in question  
Hnd 11/1/83*

RESPONSES OF HAROLD W. WIESE TO  
U.S. EPA LETTER OF MAY 19, 1987  
WITH RESPECT TO DEAD CREEK AREA G  
SAUGET SITE, SAUGET, ILLINOIS

EXHIBIT 2A4

ST. CLAIR COUNTY, ILLINOIS  
T 2 N-R 10 W

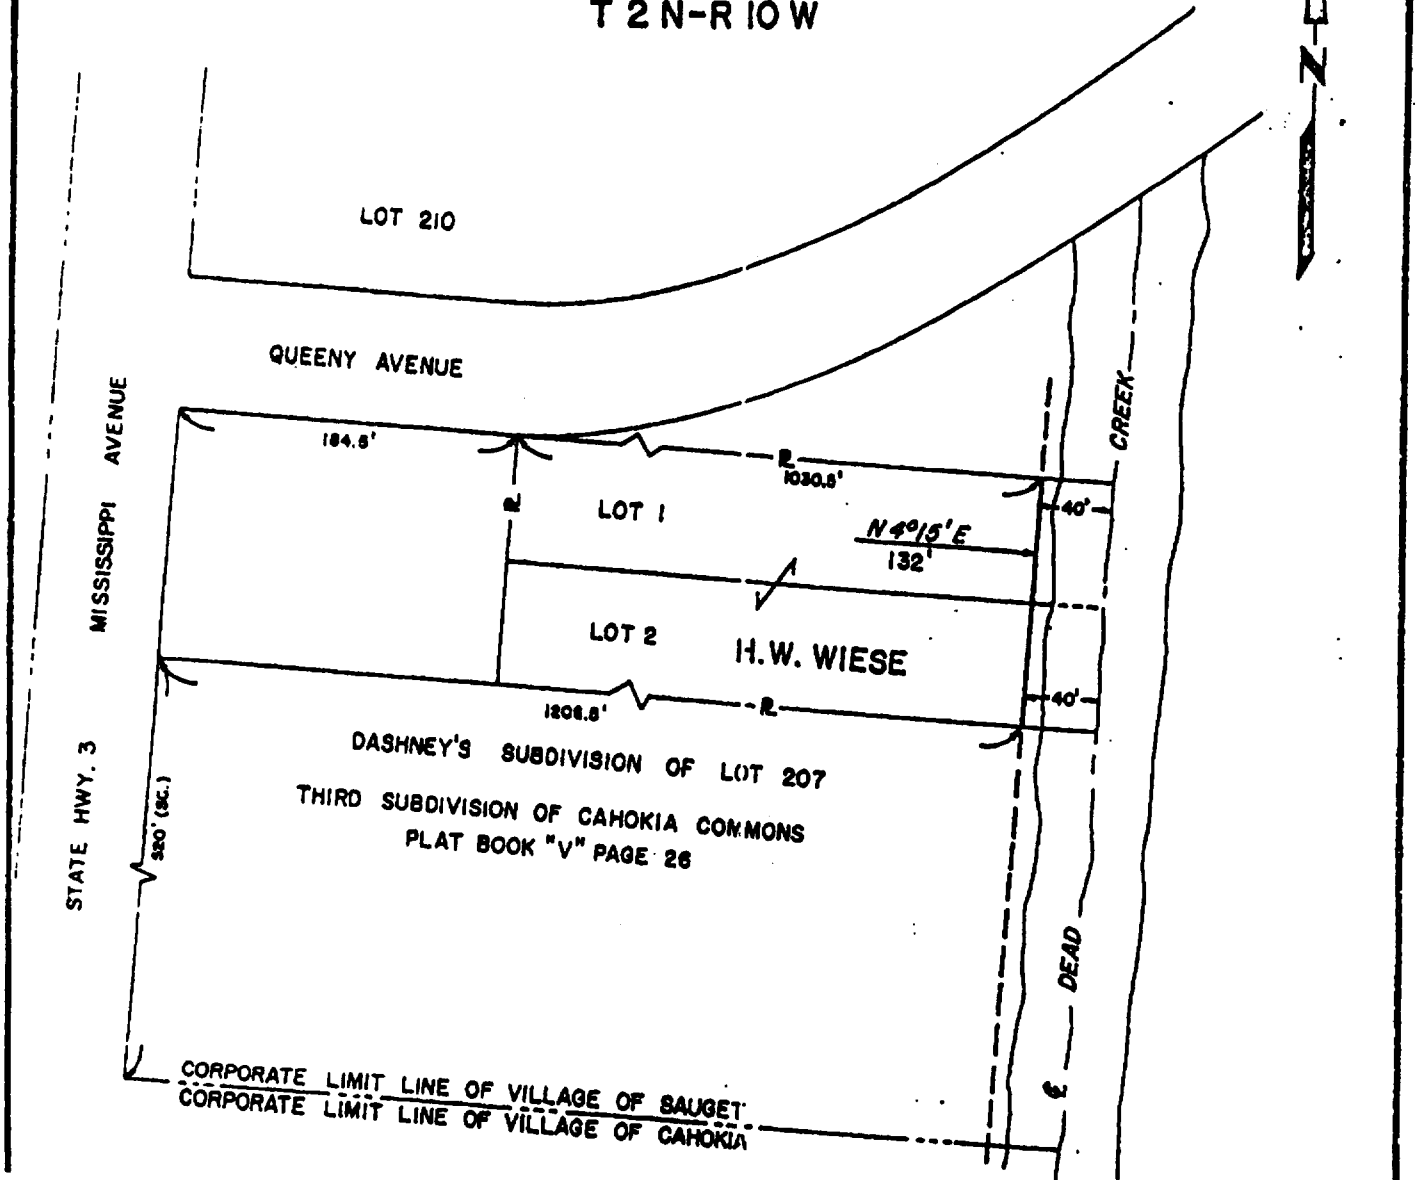

RESPONSES OF HAROLD W. WIESE TO  
J.S. EPA LETTER OF MAY 19, 1987  
WITH RESPECT TO DEAD CREEK AREA G  
SAUGET SITE, SAUGET, ILLINOIS

EXHIBIT 2A5

EXHIBIT "A"

SCALE: 1"=100'

REF. 632-AA-1001, TR. 10

**EXPLORER PIPELINE COMPANY**

**TULSA, OKLAHOMA**

**14" PIPELINE CROSSING THE PROPERTY OF  
H.W. WIESE**

**ST. CLAIR COUNTY T2N-R10W ILLINOIS**

**DRAWN KAH**

**CHK'D. TMC**

**DATE 1-31-73**

**APPR'D. JBB**

**532-LP-1006**